REVISIONS				
ZONE	LTR	DESCRIPTION	DATE	APPROVED
		ISSUED FOR APPROVAL		
	A	UPDATED AS PER CUSTOMER	08 JAN 04	
	B	WINDOWS REMOVED	09 JAN 04	
	C	AS-BUILT	10 MAR 04	

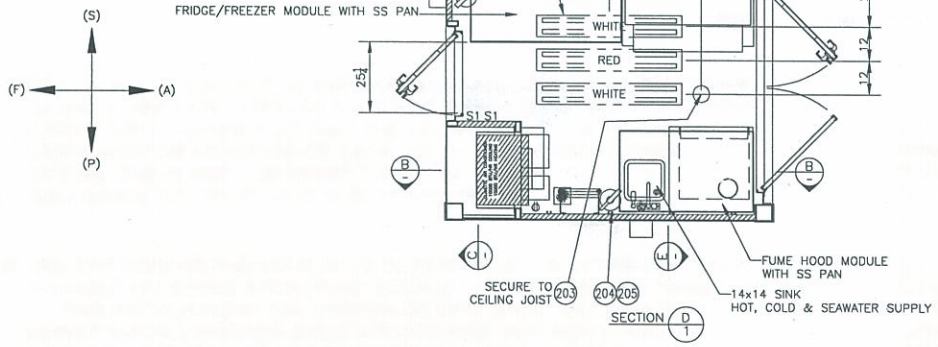

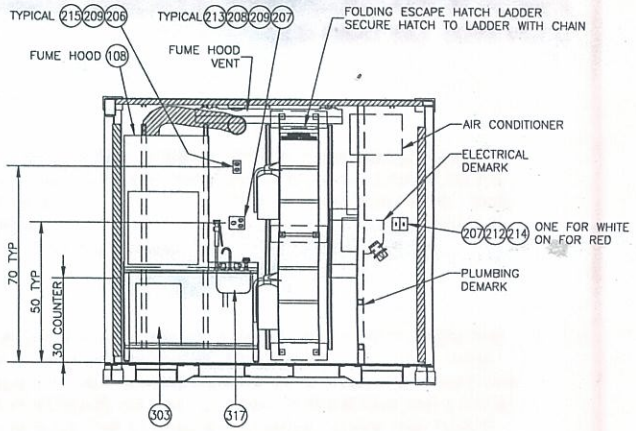

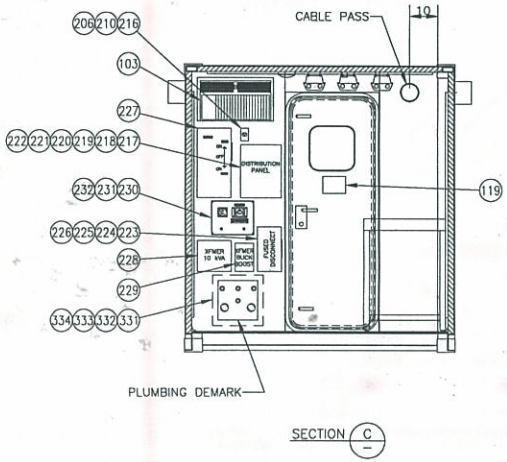

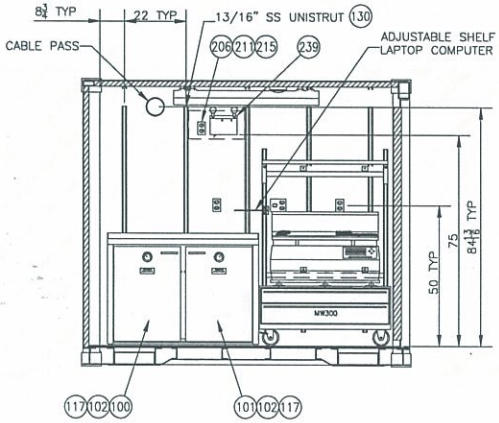

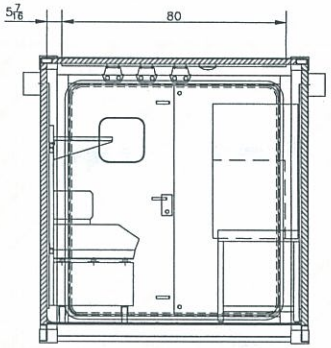

NOTES:-

1. ALL VERTICAL ELECTRICAL WIRING TO RECEPTACLES TO BE SURFACE MOUNTED USING 1/2" EMT.
2. ALL OTHER ELECTRICAL WIRING TO BE SURFACE MOUNTED USING 3/4" EMT.
3. ALL RECEPTACLES & SWITCHES TO BE MOUNTED DIRECTLY ON WALL STUDS UNLESS OTHERWISE SPECIFIED.
4. CONDUIT IS TO BE RUN ON THE WALL SURFACE AND NOT ON THE UNISTRUT.
5. MINIMUM WIRE SIZE IS TO BE #12AWG.
6. ALL CABLE/WIRE TO BE STRANDED, XLPE-90.

THIS IS A PROPRIETARY DESIGN OF SONIC ENCLOSURES LTD. MANUFACTURE, REPRODUCTION OR USE OF ANY ASSEMBLY, SUBASSEMBLY OR PART IS NOT PERMISSIBLE EXCEPT IF EXPRESSLY PRIOR AUTHORIZED IN WRITING BY SONIC ENCLOSURES LTD.

UNLESS OTHERWISE SPECIFIED DIMENSIONS ARE IN INCHES
TOLERANCES
FRACTIONAL ± 1"
DECIMAL ± .031"
ANGULAR ± 1.0°
DO NOT SCALE DRAWING

CONTRACT No. 625308		
DRAWN GUS	DATE 29 DEC 03	
CHECK		
DESIGN GUS	29 DEC 03	
DESIGN ACTIVITY		
CUSTOMER UNOLS		

SONIC
7127 HONEYMAN ST
DELTA B.C. V4G 1E2
PH- 604 946-6100
FX- 604 946-6967

TITLE
10' ALUMINUM ISOTOPE VAN
INTERIOR VIEWS

SIZE	FSCM NO	DWG No	REV.
		625308-02	C

SCALE 1:40 | RELEASE DATE | SHEET 2